

# CENTERLINE TIE PLAT

3-5-98 ~~2-28-98~~  
~~12/7/97~~  
 Date: ~~2-1-97~~

Surveyed by: Research Enterprises, Santa Ana

Sheet \_\_\_\_\_ of \_\_\_\_\_

Project of Survey: Centerline Ties

Sheet \_\_\_\_\_ of \_\_\_\_\_

Parcel Map # \_\_\_\_\_

L.S. 4749

FB-331 P. 325

Drawn by: G.B.

Date: \_\_\_\_\_

Grid \_\_\_\_\_

MB \_\_\_\_\_

## LEGEND


### Found

- Found Well monument
- ⊗ Found Spike & washer
- Found Nail
- + Found Lead & Tack
- ⊕ Found Chiseled Plus +
- △ Found nothing
- P.K. Found P.K. Nail
- C.N. Found Concrete Nail
- Found City Eng Tag
- ⊙ Found M.H./Punch Marks

### Set by Research Ent.

- Chiseled T
- Lead & Tag
- Spike & Washer
- M Measured distance as noted
- X Set Concrete Nail

NOTE: TANGENT OVER TIE LINES  
 EXCEPT DISTANCES MARKED P.T. (PULL TIE)

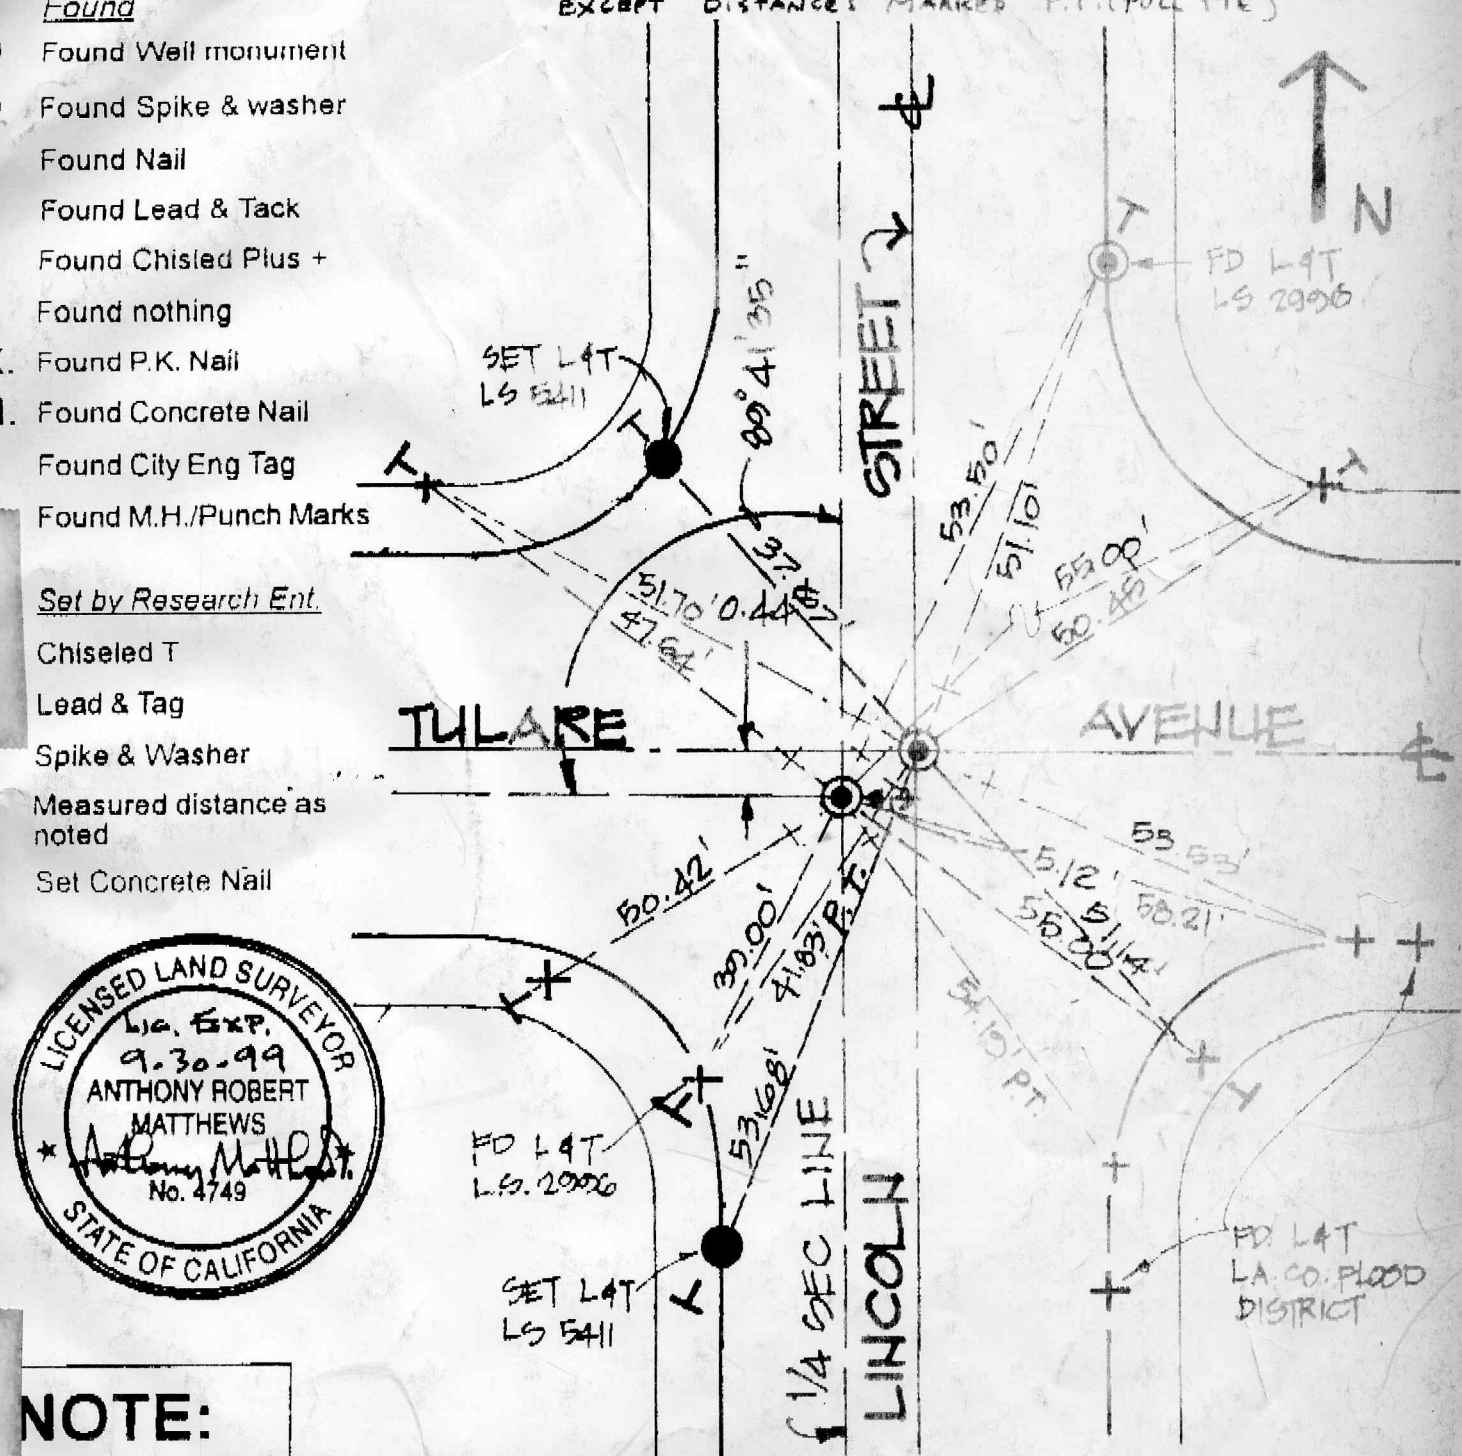

**NOTE:**  
 Measurements were taken with both ends of tape flush with ground (not chain measurement).